



BUILDING 33  
GROUND FLOOR PLAN  
SCALE 1:200

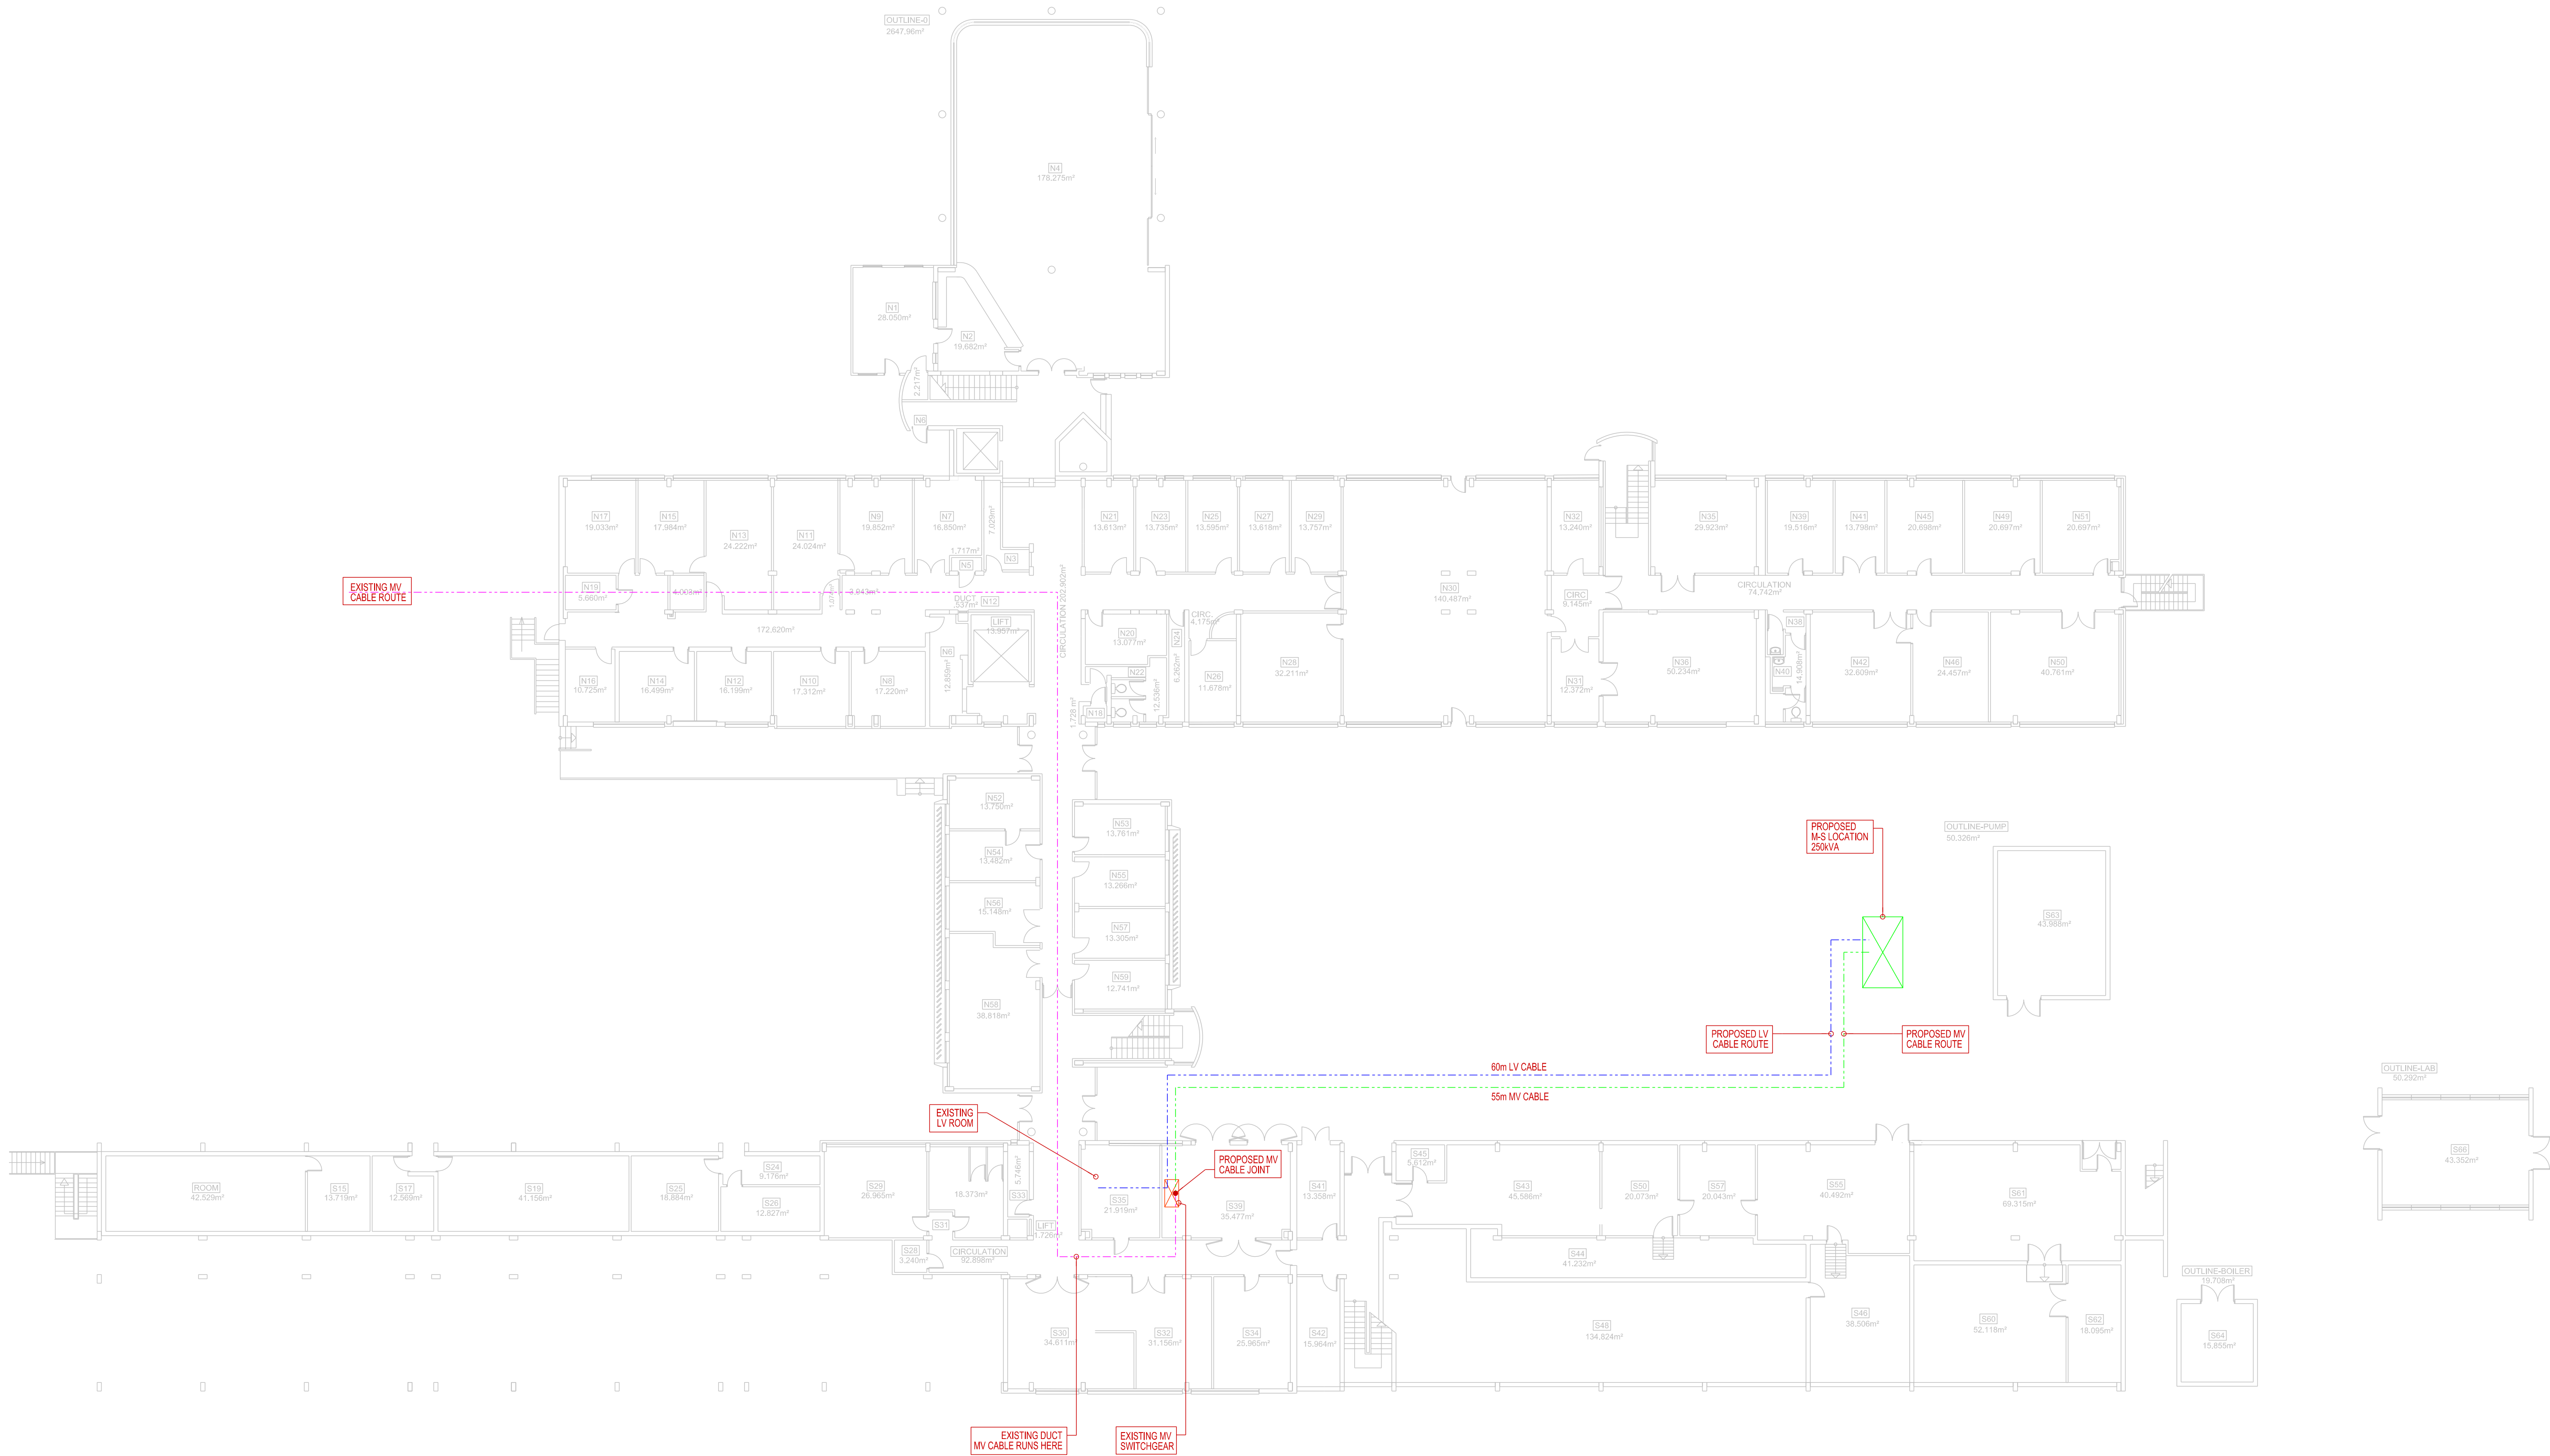

1		24.02.14	UPDATED AS-BUILT DRAWING	R.V.R.
0		20.02.12	AS-BUILT	R.V.R.
Rev.	Date	Description of Revision	Prepared By Signature	
Client:				
 CSIR Facilities Building 35 627 Maitland Naudé Road Pretoria <i>our future through science</i>				
Project Description:				
CSIR CAMPUS PRETORIA				
Scale:		Date:		
1:200 / A1		24/02/2014		
Document Title:				
BUILDING 33 EXISTING & PROPOSED CABLE ROUTES				
Drawing Number:		Page:		Revision:
33FP0-1		1/1		0
		Page Size:		A1