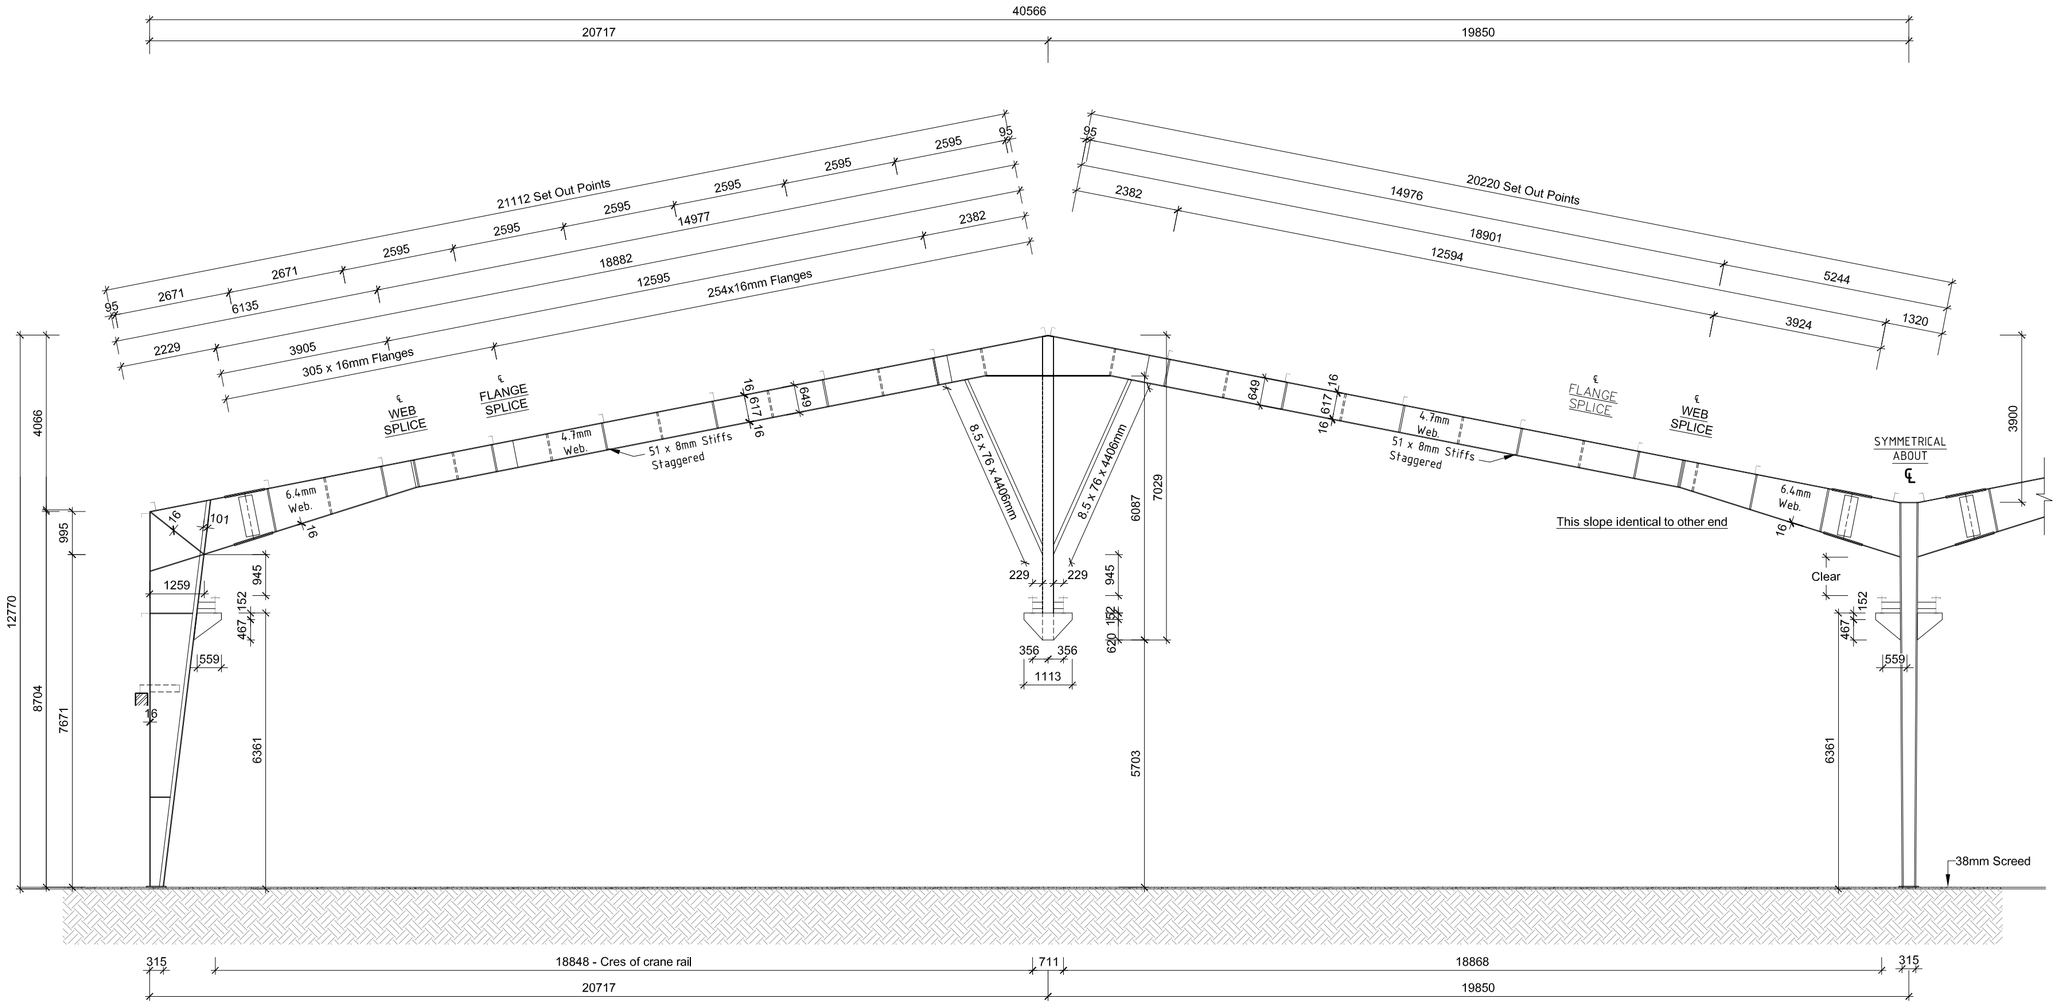

LAY-OUT OF PORTAL - FRAMES ON PRE-SETTING LINES

SCALE 1:100

NO.	DATE	AMENDMENT

Client

Drawn By

Tel: +27(0) 861 276 266
archsw@csmeng.co.za

www.csmeng.co.za

Discipline: Structural

Project: HYDRO-MECHANIC LABORATORY

Signed by

Client: _____

Engineer: _____

Drawing title: LAYOUT OF PORTAL (AS-BUILTS)

Date	08/Nov/2011	Designed	–
	AS-BUILTS	Drawn	Z.B
Scale	1 : 100	Checked	–
Size	A1	Revision	–

Dwg No: 01117SES/AS/01

FOR: **INFORMATION**